

BENSALEM TOWNSHIP

Building and Planning Department 2400 Byberry Road • Bensalem PA 19020 215-633-3644 • FAX 215-633-3653

Exhibit Z-4

Zoning Hearing Board

Appeal	Number:	
		Township of Bensalem, Bucks County, Pennsylvania Notice of Appeal
	is hereby ma applicable i	ade by the undersigned from the action of the Zoning Officer. tem(s):
	Application Administrat Special Exc	
Annell		om the terms of the Zoning Ordinance of the Township of Bensalem A.T. Chadwick Company, Inc.
Address:		100 Dunksferry Road
		Bensalem, PA 19020
Phone	No.	Denoticin, 17 13020
Owner's Name:		Albert T. Chadwick
Addres	s:	100 Dunksferry Road
		Bensalem, PA 19020
Phone No.		
e.		
Attorney Name:		
Address:		
Phone No.		
Interest	t of appellan	t, if not owners (agent, lessee, etc.):


Check items if applicable: Use Lot Area Height Yards **Existing Building** XX **Proposed Building** Occupancy Other: (describe) new parking / Proposed Building X 2. Brief description of Real Estate affected: Tax Parcel Number: 02-068064 Location: 100 Dunksferry Road, Bensalem, PA 19020 Lot Size: 15.992 AC Present Use: Office / Parking Proposed Use: Office Building / Additional Parking Present Zoning Classification: R-55 Riverfront Revitalization District Present Improvement upon Land: Office & industrial buildings along with parking Deed recorded at Doylestown in Deed Book 0220 Page 879 3. If this is an appeal to challenge, provide statement and/or basis for challenge to the validity of the zoning ordinance. 4. If this is an Appeal from action of the Zoning Administrative Officer then complete the following: Date Determination was made: N/A Your statement of alleged error of Zoning Administrative Office:

1. Application relates to the following:

 Specific reference to section of the Zoning Ordinance variance is based (if special or variance is desired): A v 	upon which application for special exception or variance is requested from Section 232-275 (2)
for lot coverage which is required to be 55% a for the site which is required to be no less t	and from the required natural state area
Action desired by appellant or applicant (statement of desired):	relief sought or special exception or variance
We are requesting a variance be granted allowing and proposed remaining natural state area of 2	ng proposed lot coverage of 74.2%
 Reasons appellant believes board should approve de ordinance under which it is felt that desired action may not) claimed, and the specific hardship. 	esired action (refer to section or sections of be allowed, and not whether hardship is (or is
We believe the requested variances should be gr non-conforming with an existing lot coverage of area of 28%. We located the proposed additions	72% and a remaining natural state and parking with additional planting
areas in locations that were already impervious -SEE ATTACHMENT FOR ADDITIONAL RESPONSE	s surface to minimize the impact on the site
8. Has previous appeal or application for special exception premises?	or variance been filed in connection with these
YES NO	
Specifications of errors must state separately the appellant's administrative office with respect to each question of law and	objections to the action of the zoning difact which is sought to be reviewed.
I, hereby depose and say that all of the above statements and or plans submitted herewith, are true to the best of my knowled	d the statements contained in any papers edge and belief.
	March 15, 2016
Appellant's or Owner's Signature	Date
Sworn to and subscribed before me this	
15th day of March 2016	
	COMMONWEALTH OF PENNSYLVANIA
Notary Public	NOTARIAL SEAL
My commission expires: 6-15-2018	JENNA M SEUFFERT Notary Public BENSALEM TWP. BUCKS COUNTY My Commission Expires Jun 15, 2018

CONTINUED FROM PAGE 6
ADDITIONAL RESPONSE FOR ITEM 7:

We are only increasing the site lot coverage by 2.2% and reducing natural state area by 2.3% less than what is currently on site. Our proposed building coverage is 10.3% below the maximum 35% allowed by the zoning the the R-55 district. The lot coverage and natural state area is mostly being utilized to provide the required parking per Bensalem Township ordinance section 232-586 Off-Street Parking. The owner is looking to stay at the existing site in Bensalem and continue to grow his existing business. In order to do so, expansion of the existing buildings is required. By expanding the buildings, he needs to meet the parking requirements which is forcing him to increase the existing lot coverage over what is allowed.

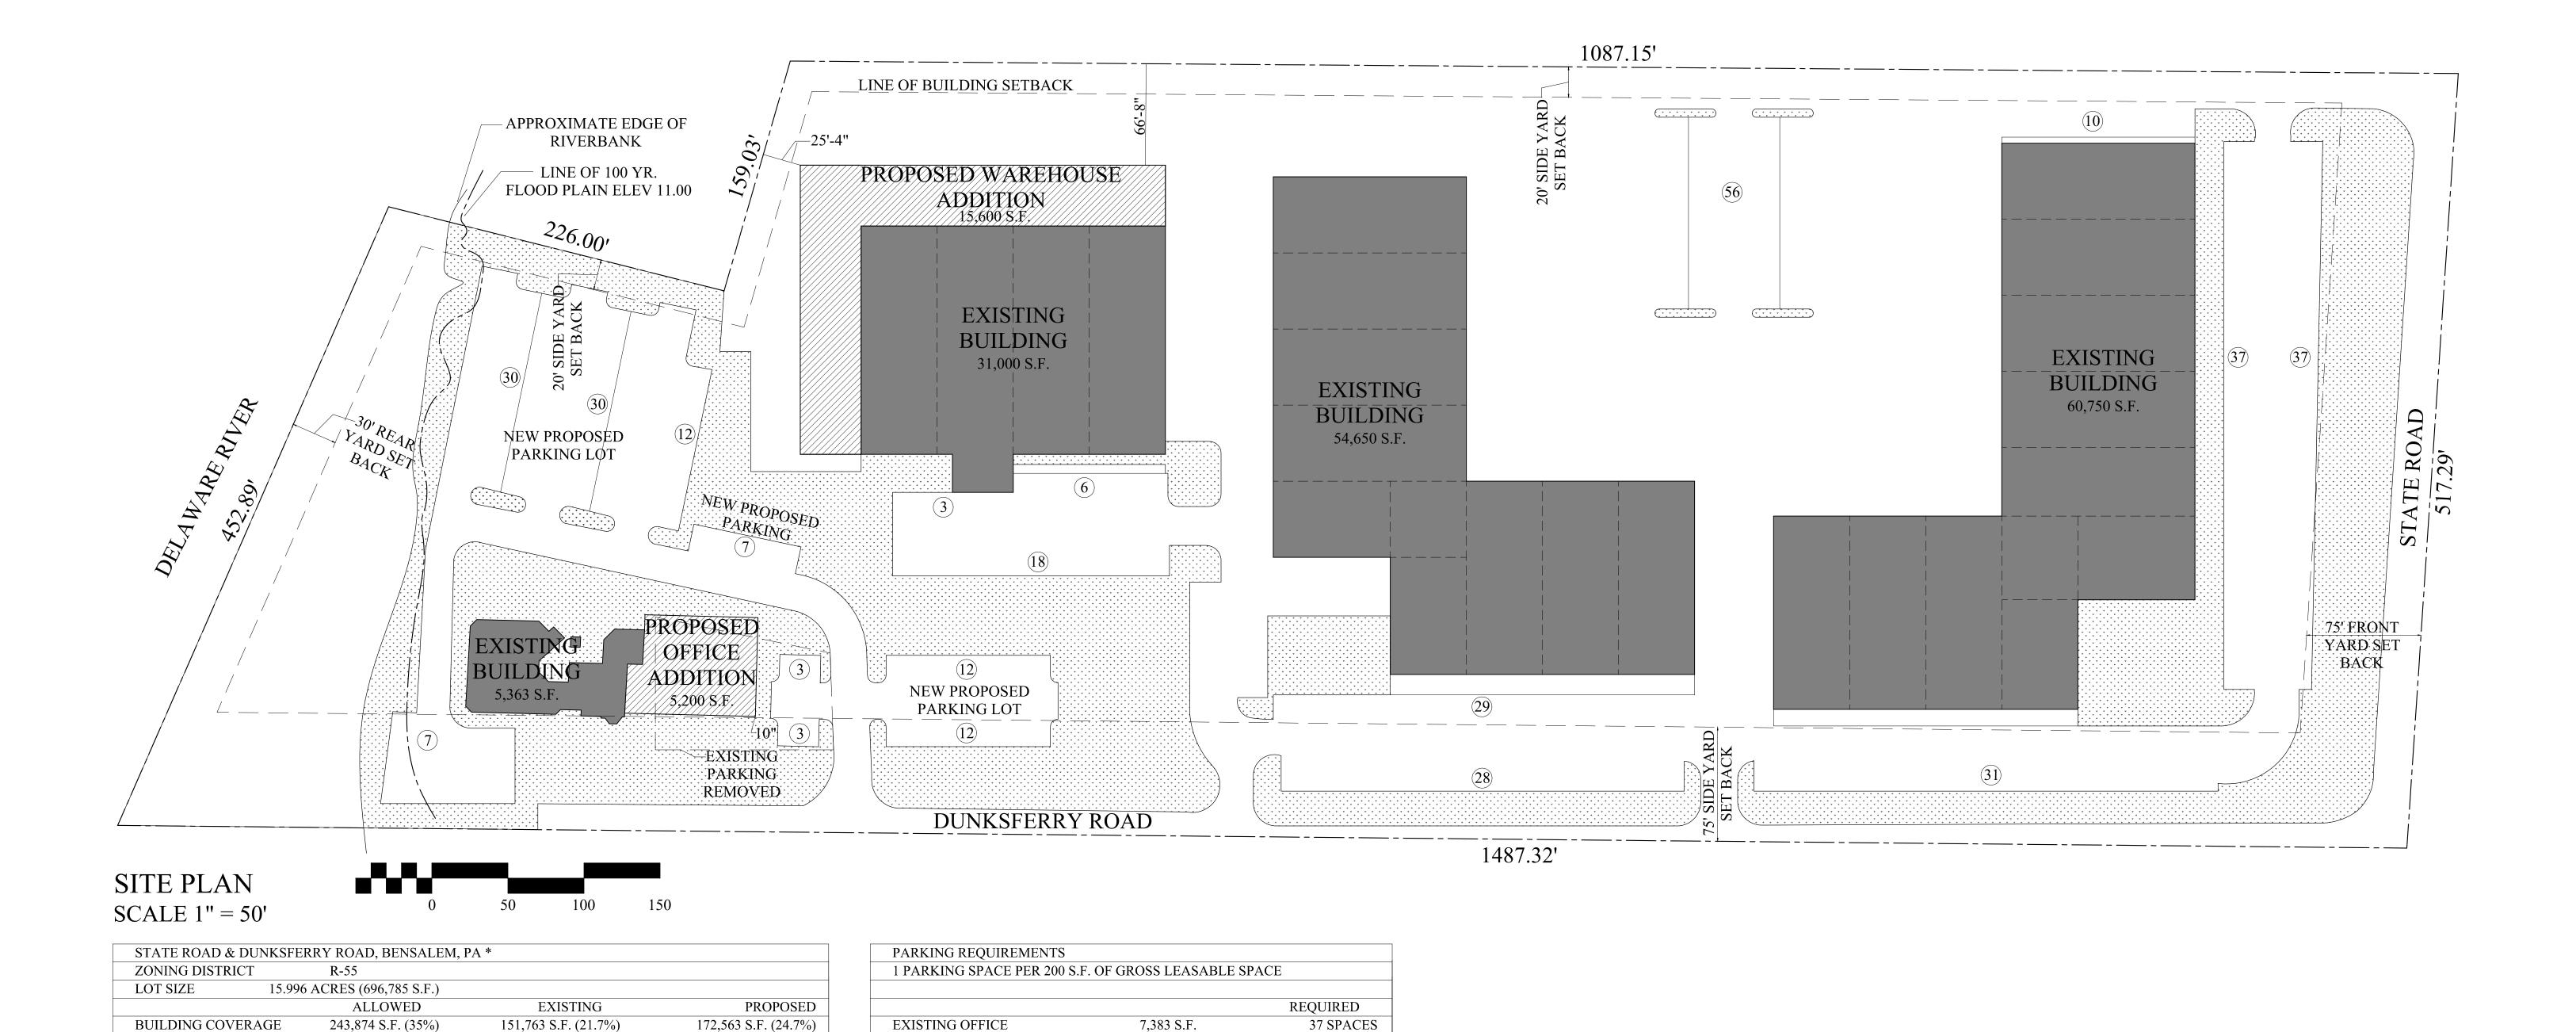

^{*} SITE INFORMATION DEVELOPED FROM PLANS ORIGINALLY PREPARED BY WILLIAM G. MAJOR ASSOCIATES DATED JULY 8, 2002

497,662 S.F. (72%)

199,123 S.F. (28%)

517,390 S.F. (74.2%)**

179,395 S.F. (25.7%)**

PROPOSED OFFICE

TOTAL SPACES PROVIDED

TOTALS

383,231 S.F. (55%)

313,553 S.F. (45%)

A.T. Chadwick 100 Dunks Ferry Road Bensalem, PA 19020

78 SPACES

115 SPACES

116 SPACES

15,600 S.F.

22,983 S.F.




Christopher J. Luce, AIA NY 037335-1 NJ 21AI01673300

67 Byberry Road, Hatboro, PA, 19040 Phone: 215-674-5950 * Fax: 215-674-5952 WWW.LUCEARCHITECTS.COM

LOT COVERAGE

NATURAL SPACE

^{**} PROPOSED CHANGES WOULD REQUIRE ZONING VARIANCE

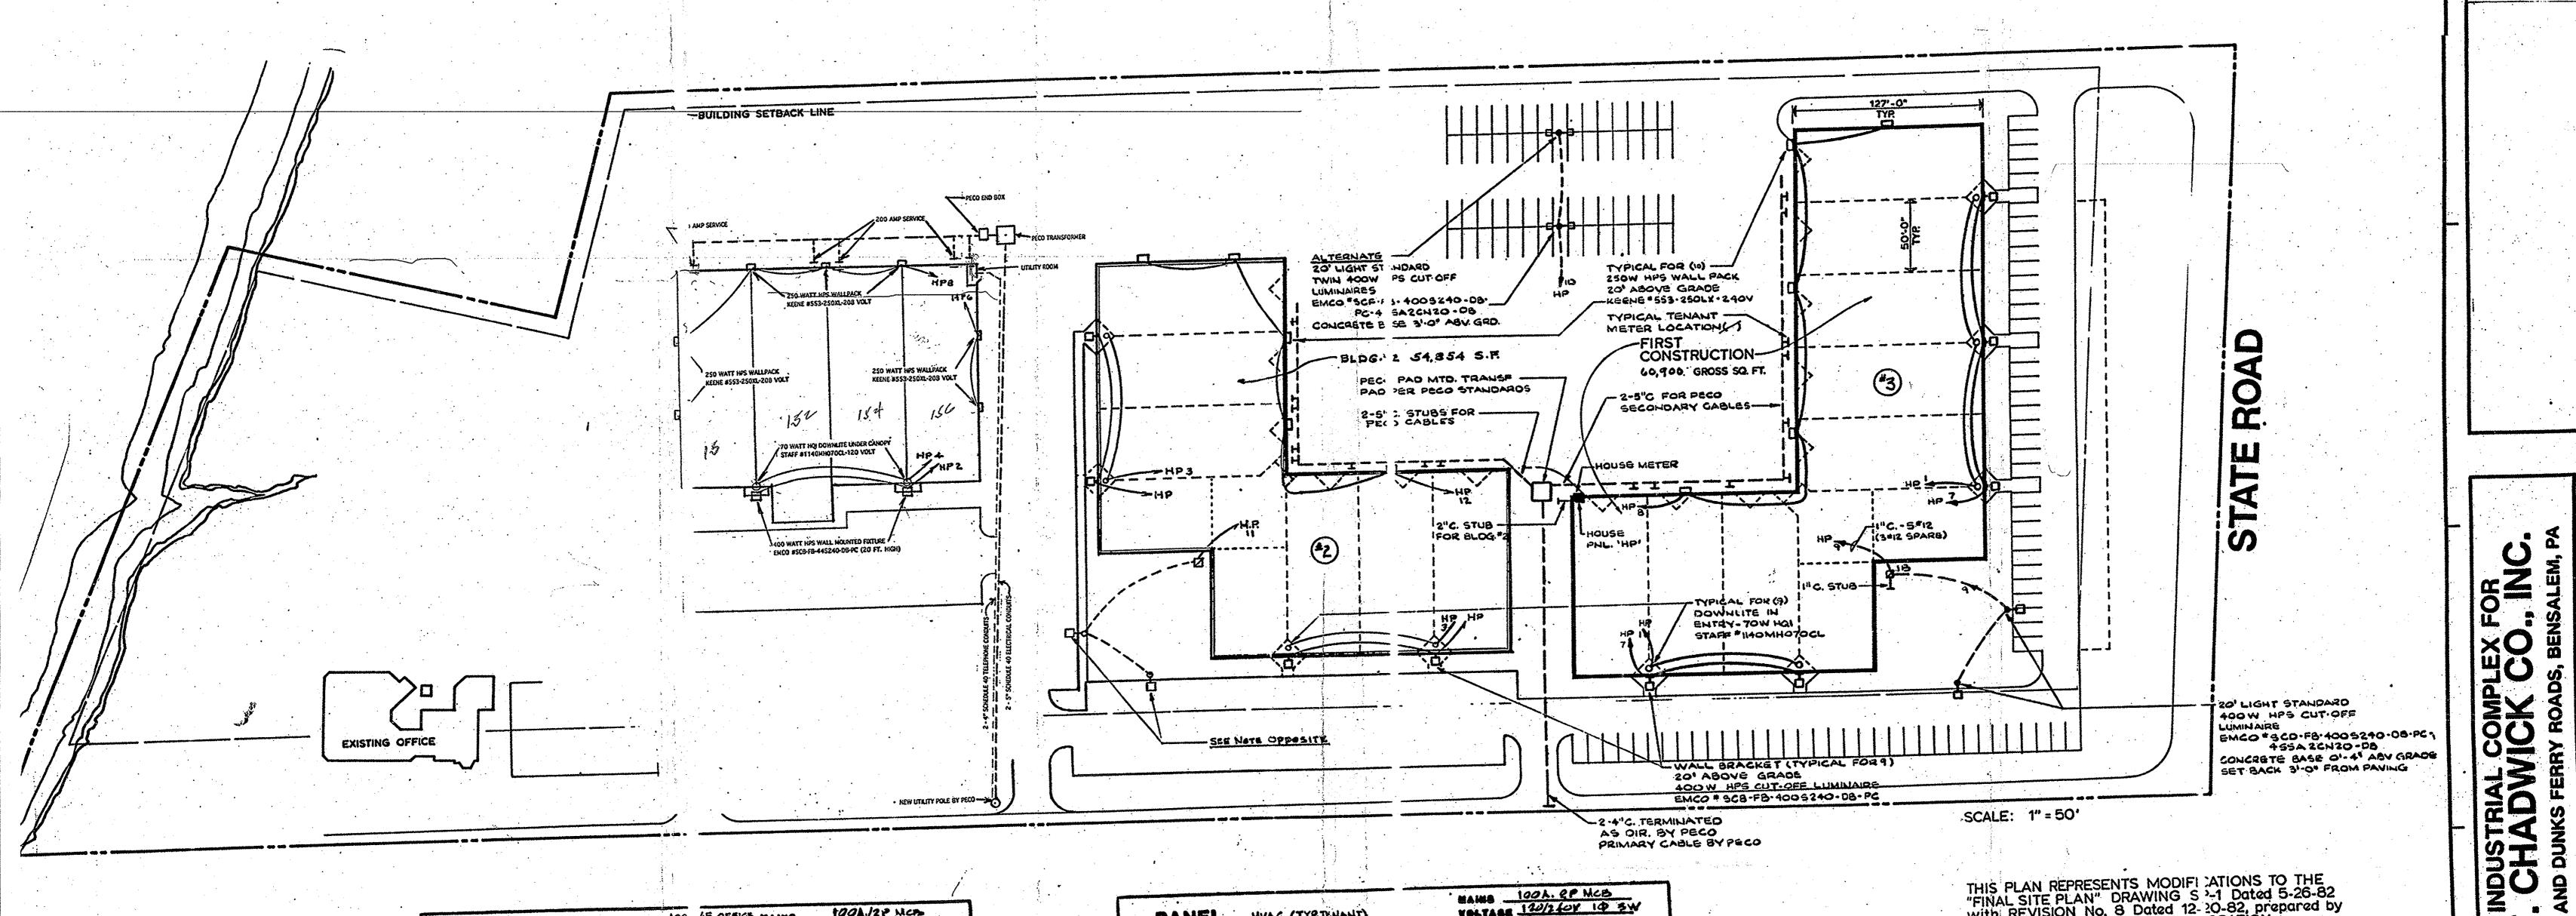

(2) 4342-1446 THIN PECO SERVICE HOUSE SINGLE LINE DIAGRAM VIETHIA.

אבני שביניונב

PANEL GLP (TYP.TEHANT) 520 SP. STOR. VOLTAGE 120/2404 14 3W R CIR BKR LOCATION CIR CIR. BICK NO. LOAD SIZE LOCATION 1000 20/1 OFFILE RECEPTS. 1 1200 291 OFFICE LTG. 3 1200 OFFICE LTG. +T.R.E.E. 1 1100 WAREHOUSE RECEPTS \$ 1400 WAREHOUSE LTG. .400 U.H. -WAREHOUSE 900 400 4 900 SPARS 1/2 SPACE 18 4500 20/2 WATER HEATER

LOND SUMMARY (TYPHAL TENAUT)

B.AKW 5.1 KW RELEPTS 1.5KW WATER HTR. MISC. 3.6 KW SUB-TOTAL 9.0 KW

TOTAL CONN 28.6 KW + 124 KY = 119 AMPS

PANEL .			HVAG CTYRTHAUT)	WAMS 100A. OF MCB VOLTAGE 120/240Y IQ SW			
	CER.		LOCATION	2.	LOAD	SKR SIZE	LOCATION
			ST 274 (#10)	=	9000	60/2	OFFICE HEATING (%)
4	2 400		SPACE			. 12	SPACE
-		10				1/3	

14 KW INDIVIOUAL FUSED SWITCHES MAY BE USE IN LIEU OF PANEL

PANEL HP				WANS 100A. 2P. MCB WOLTAGE 120/240VID 3W				
CIR.	CIR.	SIZE	LOCATION .	-	2	CIR.	SIZE	LOCATION
	500	20/1	ENTRY LTS 45				20/1	
8	400			L				
5				-	•			
7	2250	20/2	WALL BETS - FRONT 3	Ļ	1	1500	20/2	WALL BUTS- REAR 43
•	900	1-1-	STANDARDS - FRANT'S	_	3	1500		STANDARDS-PEAR WALL BKTS-REAR 42
11	900				_ _	1,700		

NOTES.

I. PHOTOCELL CONTROLLED CONT. CTOR MAY BE USED TO CONTROL
EXTERIOR LIGHTS IN LIEU OF INDIVIDUAL PHOTOCELL AT EACH LUMINAIRE 2. PHOTOCELL REQUIRED TO CONTRI . CIRC'S. 1 4 8; 3 \$ 12


2400 W

THIS PLAN REPRESENTS MODIFI ATIONS TO THE "FINAL SITE PLAN" DRAWING S >-1 Dated 5-26-82 with REVISION No. 8 Dated 12-20-82, prepared by ENVIRONMENTAL DESIGN CORI ORATION. See that drawing for metes & bc Inds, topography, and other technical information

TOTAL GROSS SQUARE FOOTA & OF NEW CON-STRUCTION (This plan, including future): 167,566 sq. ft. Total square footage (1982 plan): 191,200 sq.ft.

BOCA. BUILDING CODE: Use Group Construction Type

PENNSYLVANIA FIRE & PANIC REGULATIONS: Occupancy Group D-O
Construction Type Noncombustible

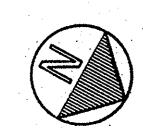

BLDG. \$ 1 A 3/9/2 BLDG 2 9/5/2 BL04 12 DATE 24 AUG. 1987 DRAWN BY KC COMM. NG. 8701 ELECTRICAL:

TYPICAL TENANT SINGLE LINE DIAGRAM



BENSALEM TOWNSHIP

Building and Planning Department
Office 215-633-3644 • Fax 215-633-3753
Matthew K. Takita

Director of Building and Planning 2400 Byberry Road • Bensalem, PA 19020

February 5, 2016

A.T. Chadwick Co. Inc. 100 Dunksferry Rd Bensalem, PA 19020 Project:

OFFICE ADDITION

Project Address:

100 DUNKSFERRY RD BENSALEM, PA 19020

02-068-064

Tax Parcel: Property Owner:

SAME AS ADDRESSED

Permit Status:

APPLICATION DENIED

Electronic Review Status

Dear Sir/Madam:

A review was conducted on the application for the referenced project pursuant to Chapter 232 ZONING, The attached sheets show what was found during the review and this information is required to complete the permit application for the above referenced project.

The review process utilizes Adobe Acrobat allowing reviewers to make their comments directly on the plan pages. These comments are tracked throughout the review and a printed summary serves as the basis for a rejection on the project until required changes have been made. The attached sheets will show an image of the plan page including its associated comments with connector lines. Only those pages of the plans that require a revision have been generated and included.

You are required to resubmit plans with revisions and will need to burn the **complete** set of plans with revisions to a new disc. Return it to the Building & Planning Department. You are to include a summary list of **all** changes that were made to the plans including those required by the Township. For each change made to the plans, note the sheet number, drawing title, and a brief description of the change made. Please label the disc with the project address, date and revision number to distinguish it from any earlier submissions.

It is our intent that you receive as few rejections as possible and provide reviewers a more efficient method for completing the review by utilizing the comments summary. The print dialog box should include the following summary options:

- * Layout Document and comments with connector lines on single pages
- * Font Size Large font size
- * Include all comments
- * Clear the checkbox to NOT include pages containing no comments

It is possible that upon receipt of the revised plans, additional items for compliance may be required. This letter shall serve as formal notice that your permit application has been rejected for said project until such time as the requested information has been provided.

You have the right to appeal this rejection letter. Applications for the Zoning Hearing Board can be obtained from the Building and Planning Department located in the Municipal Building at 2400 Byberry Road, Bensalem.

Respectfully.

Harold W. Gans, P.E., P.L.S. Township Engineer

Email address

HWG/Iva Enclosures

